Tuesday, 16/10/2007 10:16:59 AM

User

Linda Lacelle

**Process Sheet** 

Customer

: CU-DAR001 Dart Helicopters Services

Job Number

: 35177B

Type

**Estimate Number** 

: 10193

P.O. Number

: 16/10/2007 This Issue

Prsht Rev. : NC

First Issue **Previous Run** 

: 11 : 35105B

Written By

Checked & Approved By

Comment

: Rev Est:M 03.01.31 RF

Added D2012-117 for D130-701-041 KJ/

S.O. No. :

Est Rev:N 06.04.05

Added level21

: LARGE FAB ASSY

EC

**Description:** 

304 SQ Tube.75x.75x.065W

**Drawing Name** 

: 350/212/130 BASKET LID

**Part Number** 

**Drawing Number** 

: D2512 REV D2

: D2512

**Project Number** 

: N/A : D2

**Drawing Revision** Material

**Due Date** 

: 23/10/2007

Qty:

J. J. C.

J.J.L. 07/10/21

J.J.L. 07/10/23

J.J.L. 07/10/21

1 Um:

07/10/21

Each

**Additional Product** 

Job Number:



Seq. #:

1.0

Machine Or Operation:

M304TS0750W065

Comment: Qty.:

45.7594 f(s)/Unit Total :

45.7594 f(s)

3/4"x3/4" 304/316 SS tube .063" wall

Batch: M 105604

2.0

D31663



Pick:

**Qty Part Number** 

1 D3166-3

1.0000 Each(s)/Unit Total:

**Basket Hoop** 

Description

Batch 34424

Placard

Basket Hoop

1.0000 Each(s)

D2506 3.0



Comment: Qty.:

Comment: Qtv.:

1.0000 Each(s)/Unit Total:

1.0000 Each(s)

Pick:

**Qty Part Number** 

1 D2506

Description Label Plate

Batch

4.0

D23271

Spacer Bushing

Comment: Qty.:

2.0000 Each(s)/Unit Total:

Bushing

2.0000 Each(s)

Pick:

**Qty Part Number** 

·2 D2327-1

Description

Page 1

Form: rprocess

Dart Ae	rospace	Ltd								
W/O:		,	W	ORK ORDER CH	ANGES					
DATE	STEP	PRO	OCEDURE CH	ANGE		Ву	Date	Qty	Approval Chief Eng / Prod Mgr	Approval QC Inspector
Part No	•	PAR #:	Fault Cat	egory:	NCI	R: Yes	No DQ	A:	_ Date: _	
						QA: N	C Close	d:	_ Date:	<del></del>
NCR:		V	VORK OR	DER NON-CONFO	RMANCE	(NCR	)			
DATE	OTED	Description of NC		<b>Corrective Action</b>	Section B		Verifi	cation	Approval	Approval
DATE	STEP	Section A	Initial Chief Eng	Action Descrip Chief Eng	otion	Sign & Date		ion C	Chief Eng	QC Inspector
								1		
				•						i

Date: Tuesday, 16/10/2007 10:16:59 AM User<sup>,</sup> Linda Lacelle **Process Sheet** Customer: CU-DAR001 Dart Helicopters Services Drawing Name: 350/212/130 BASKET LID Job Number: 35177B Part Number: D2512 Job Number: Seq. #: **Machine Or Operation:** Description: 5.0 D22321 Hinge Comment: Qty.: 2.0000 Each(s)/Unit Total: 2.0000 Each(s) J.J.L. 07/10/23 Pick: **Qty Part Number** R 3/608 Description 2 D2232-1 Hinge plate D2581 6.0 Mounting Bracket J.J.L. 07/10/23 Comment: Qty.: 2.0000 Each(s)/Unit Total: 2.0000 Each(s) Pick: **Qty Part Number** Description 24445 Mounting Bracket  $\, \mathcal{B} \,$ 2 D2581 7.0 M304EX07516F Expanded Metal Flat Stai J.J.L. 07/10/24 Comment: Qty.: 18.0000 sf(s)/Unit Total: 18.0000 sf(s) Pick: 18 sf M304EX0.75-16F Expanded Metal M105913 LARGE FAB 1 8.0 LARGE FABRICATION RESOURCE 1 Comment: LARGE FABRICATION RESOURCE 1 J.J.L. 07/10/25 1-Cut 3/4" x 3/4" square tubing as per Dwg D2512 2-Cut (4) D2236 From D3166-3 3-Drill holes in D2512-1 as per Dwg D2512 using Drill Jig DT8305 5-Weld as per Dwg D2512 using Welding Table and corner Jig Deburr as required 9.0 VISUAL WELDING INSPECTION 07-10-260 Comment: VISUAL WELDING INSPECTION

	•									
W/O:			V	WORK ORDE	R CHANGE	S			<del>- · · · · · · · · · · · · · · · · · · ·</del>	
DATE	STEP	PR	OCEDURE CI	HANGE		Ву	Date	Qty	Approval Chief Eng / Prod Mgr	Approval QC Inspector
								·		
Part No		PAR #:	Fault Ca	itegory:		NCR: Yes	No <b>DQ</b>	A:	_ Date: _	
						QA: N	/C Close	d:	_ Date: _	
NCR:		,	WORK OR	DER NON-CO	NFORMAN	ICE (NCF	2)			
DATE	STEP	Description of NC		Corrective Ac			Verific	ation	Approval	Approval
	J.L.	Section A	Initial Chief Eng	Action D	escription of Eng	Sign 8 Date	Secti	on C	Chief Eng	QC Inspector
							X .			
					-					

Date: Tuesday, 16/10/2007 10:16:59 AM User: Linda Lacelle **Process Sheet** Drawing Name: 350/212/130 BASKET LID Customer: CU-DAR001 Dart Helicopters Services Job Number: 35177B Part Number: D2512 Job Number: Seq. #: Description: **Machine Or Operation:** 10.0 QC6 DIMENSIONAL CHECK Comment: DIMENSIONAL CHECK -10-26 11.0 POWDER COATING Comment: POWDER COATING Powder Coat White Gloss (Ref: 4.3.5.1) as per QSI 005 4.3 HAND FINISHING1 HAND FINISHING RESOURCÉ# 12.0 Comment: HAND FINISHING RESOURCE #1 Wing Walk and Spray Paint black as per Dwg D2512 and QSI 005 4.4 Batch: M INSPECT POWDER COAT/CHEMICAL CONVERSIO 13.0 QC3 Comment: INSPECT POWDER COAT/CHEMICAL CONVERSION 14.0 PACKAGING RESOURCE #1 Comment: PACKAGING RESOURCE #1 Identify and Stock Location: 15.0 QC21 FINAL INSPECTION/W/O RELEASE Comment: FINAL INSPECTION/W/O RELEASE Job Completion M. 87,0.31

Dart Ae	rospace L	-ta							
W/O:			WC	ORK ORDER CHANG	BES				
DATE	STEP	PR	OCEDURE CHA	NGE	Ву	Date	Qty	Approval Chief Eng / Prod Mgr	Approval QC Inspector
	·								
Part No	•	PAR #:	Fault Cate	jory:	_ NCR: Yes	No DQ	A:	_ Date: _	
					QA: I	N/C Close	d:	Date: _	
NCR:			WORK ORD	R NON-CONFORM	ANCE (NCI	₹)			
		Description of NC		Corrective Action Sec	tion B	Verifi	cation	Approval	Approval
DATE	STEP	Section A	Initial Chief Eng	Action Description Chief Eng	Sign of Date	Sect	ion C	Chief Eng	QC Inspector
							ı		
							-		





DESIGN	BW	DRAWN BY	DART AEROSPACE LTD HAWKESBURY, ONTARIO, CANADA
CHECK	ED ,	APPROVED	DRAWING NO. REV. D D2512 SHEET 1 OF 4
DATE	713		TITLE SCALE
01.0	4.19		BASKET LID ASSEMBLY (350/212) NTS
 Α		95.11.21	NEW ISSUE
В		96.05.24	ADDED LATCH CHANNEL & LABEL PLATE
С		99.07.06	REMOVE DOUBLE SKIN SECTION, ADDED MEMBERS, INCORP. DEO 9074
· D		01.04.19	CHANGE HINGE
ÞΙ	d-10	03 01. 20	ADD DZ012-117 FOR D130-701-041


TACK WELD AND THIS AREA

RELEASED

PARTS LIST FOR D2512 BASKET LID ASSEMBLY

D2 1-08 04,59 20

PART NO	QUANTITY	LENGTH	LENGTH	DESCRIPTION
		Α	В	
D2512-1	2		25.50 <b>′,</b>	RIB
D2512-3	2		95.30 <b>√</b>	RIB
D2512-5	6	30.84 <b>V</b>		RIB
D2512-7	3	30.63		RIB
D2232-1	2	N/A	N/A	HINGE PLATE
D2236	4	N/A	N/A	RIB
D2327-1	2	N/A	N/A	BUSHING
D2506	1	N/A	N/A	LABEL PLATE
D2581	2	N/A	N/A	MOUNTING BRKT

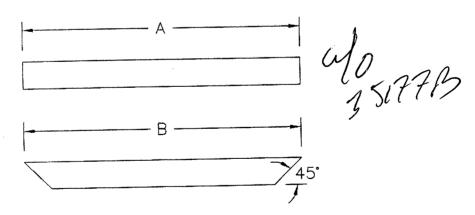


D2512-1/-3/-5/-7 CUT LENGTH/SHAPE PER DIAGRAM AND PARTS LIST MATERIAL: AISI 304/316 SS, 3/4 X 3/4 X 0.060 WALL SQUARE TUBING TOLERANCES ARE PER DART QSI 018 UNLESS OTHERWISE NOTED ALL DIMENSIONS ARE IN INCHES


Copyright © 1995 by DART AEROSPACE LTD

THIS DOCUMENT IS PRIVATE AND CONFIDENTIAL AND IS SUPPLIED ON THE EXPRESS CONDITION THAT IT IS NOT TO BE USED FOR ANY PURPOSE OR COPIED OR COMMUNICATED TO ANY OTHER PERSON WITHOUT WRITTEN PERMISSION FROM DART AEROSPACE LTD.

W/O:		to the Market Market of the Control	WC	RK ORDER CHANG	ES				
DATE	STEP	PR	OCEDURE CHA	NGE	Ву	Date	Qty	Approval Chief Eng / Prod Mgr	Approval QC Inspector
	1								
								d -	
							ļ		
								:	
Part No	:	PAR #:	Fault Cate	gory:	_ NCR: Yes	No DQ	A:	Date: _	
				• • •	QA: I	N/C Close	d:	Date: _	
NCR:			WORK ORDI	R NON-CONFORMA	ANCE (NCI	₹)			
DATE	STEP	Description of NC		Corrective Action Secti		Verific	ation	Approval	Approval
DATE	SIEP	Section A	Initial Chief Eng	Action Description Chief Eng	Sign a	Secti		Chief Eng	QC Inspector
								<u>{</u>	
	1		1 1		I	1		I .	1 1

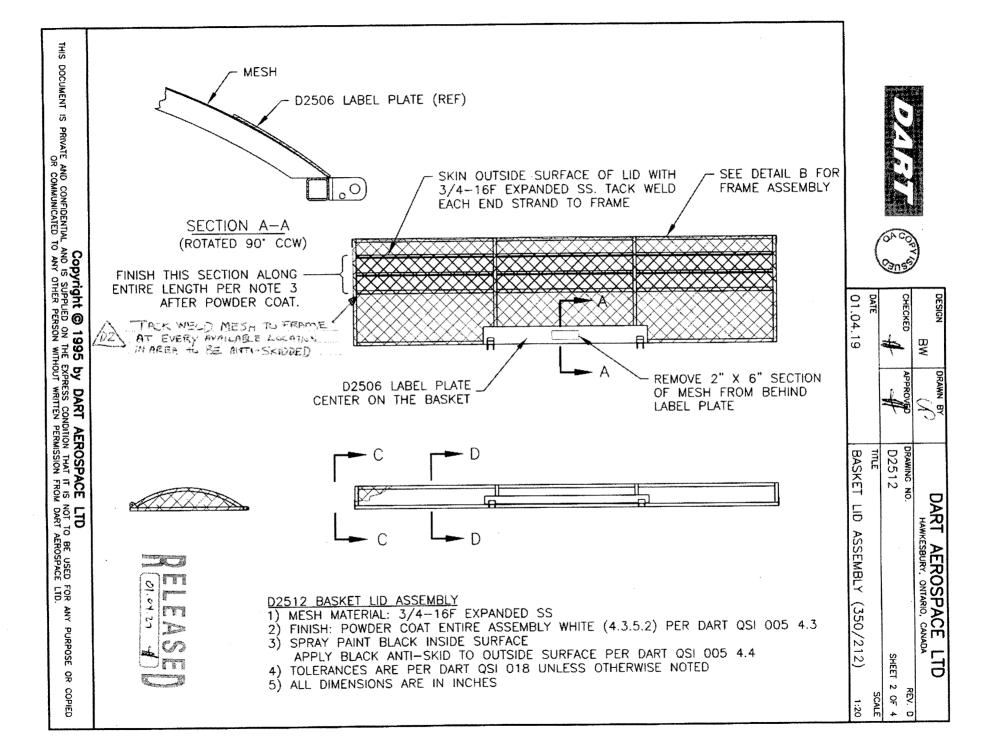

Dait Ac	ospace	Ltu								
W/O:			WC	ORK ORDER CHANG	GES.					
DATE	STEP	PR	OCEDURE CHA	NGE	E	Зу	Date	Qty	Approval Chief Eng / Prod Mgr	Approval QC Inspector
		•			,					-
			·				·-			
Part No	:	PAR #:	Fault Cate	gory:	NCR:	Yes N	lo DQ/	\ <b>\</b> :	Date:	
									Date:	
NCR:			WORK ORDE	R NON-CONFORM	ANCE (	NCR)	<del></del>			
DATE	STEP	Description of NC			tion B		Verific	ation	Approval	Approval
———	J.L.	Section A	Initial Chief Eng	Action Description Chief Eng		Sign & Date	Section	on C	Chief Eng	QC Inspector
			·							
								. 1		
						•				
. *										

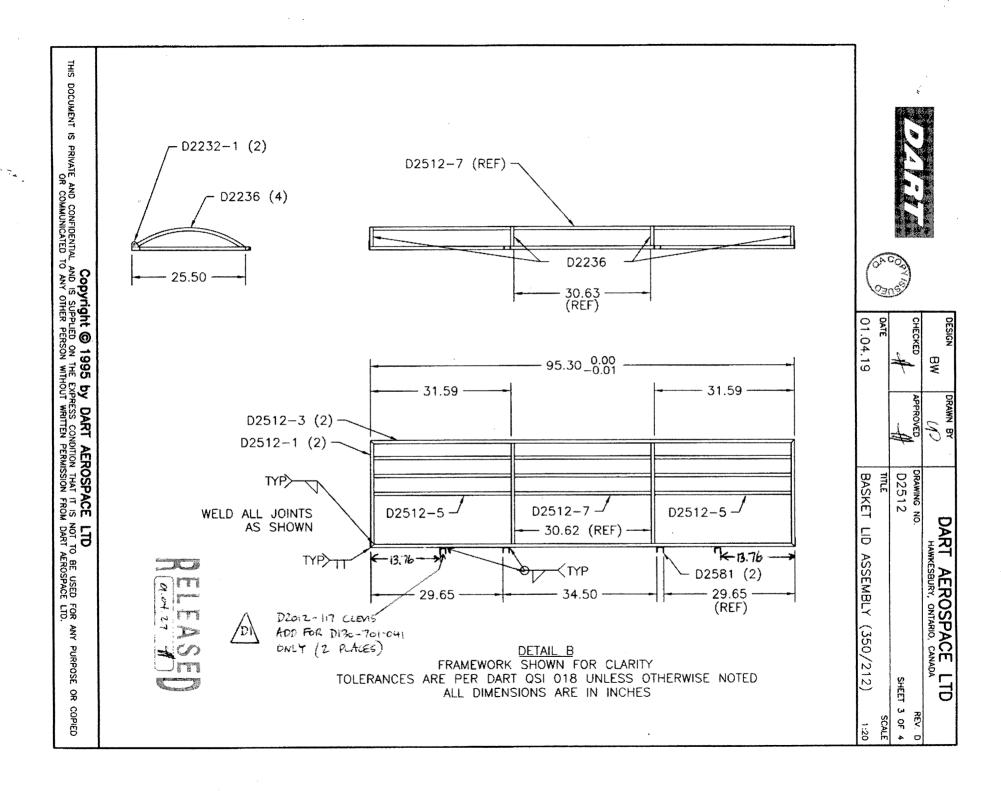


Dart Ae	rospace Lt	d							
W/O:			WC	RK ORDER CHANGES				<u>-</u>	
DATE	STEP	PR	OCEDURE CHAI	NGE	Ву	Date	Qty	Approval Chief Eng / Prod Mgr	Approva QC Inspector
							:		
							:		
Part No		PAR #:	Fault Cateo	jory: No	CR: Yes	No <b>DQ</b>	<b>\</b> :	Date:	
					QA: N	/C Closed	d:	_ Date: _	
NCR:			WORK ORDE	R NON-CONFORMANC	E (NCR	)		· · · · · · · · · · · · · · · · · · ·	
		Description of NC		Corrective Action Section B	<del></del>	Verific	ation	Approval	Approval
DATE	STEP	Section A	Initial Chief Eng	Action Description Chief Eng	Sign & Date	Section		Chief Eng	QC Inspector
t <del>ú</del> .									1
<b>13</b> .									






	DESIGN BW	DRAWN BY	DART AEROSPACE LTD HAWKESBURY, ONTARIO, CANADA	
	CHECKED	APPROVED	DRAWING NO. D2512 SHEET	REV. D 4 OF 4
Γ	DATE		TITLE	SCALE
	01.04.19		BASKET LID ASSEMBLY (350/212)	1:8

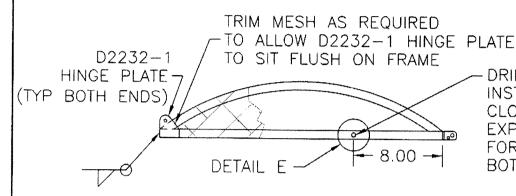


DRILL 3/8 HOLE AND INSTALL D2327-1 USING CLOSEST SPACE IN EXPANDED METAL FOR HOLE LOCATION BOTH ENDS

## SECTION C-C SIMILIAR BOTH END RIBS

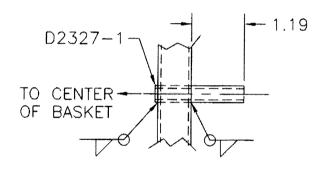

DETAIL E

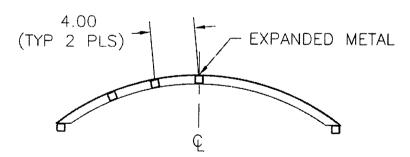

SECTION D-D SAME BOTH CENTER RIBS



Copyright © 1995 by DART AEROSPACE LTD

THIS DOCUMENT IS PRIVATE AND CONFIDENTIAL AND IS SUPPLIED ON THE EXPRESS CONDITION THAT IT IS NOT TO BE USED FOR ANY PURPOSE OR COPIED OR COMMUNICATED TO ANY OTHER PERSON WITHOUT WRITTEN PERMISSION FROM DART AEROSPACE LTD.

W/O:		WORK ORDER CHANGES									
DATE	STEP	PROCEDURE CHANGE			Qty	Approval Chief Eng / Prod Mgr	Approval QC Inspector				
		·	-								

Part No:	PAR #: _	Fault Category:	NCR: Yes No	DQA:	Date:
			QA: N/C CI	losed:	Date:

NCR:		WORK ORDER NON-CONFORMANCE (NCR)									
		Description of NC		Corrective Action Section B			Approval	Ammrayal			
DATE	STEP	Section A	Initial Chief Eng	Action Description Chief Eng	Sign & Date	Verification Section C	Chief Eng	Approval QC Inspector			
							,				
								•			
			1								